123

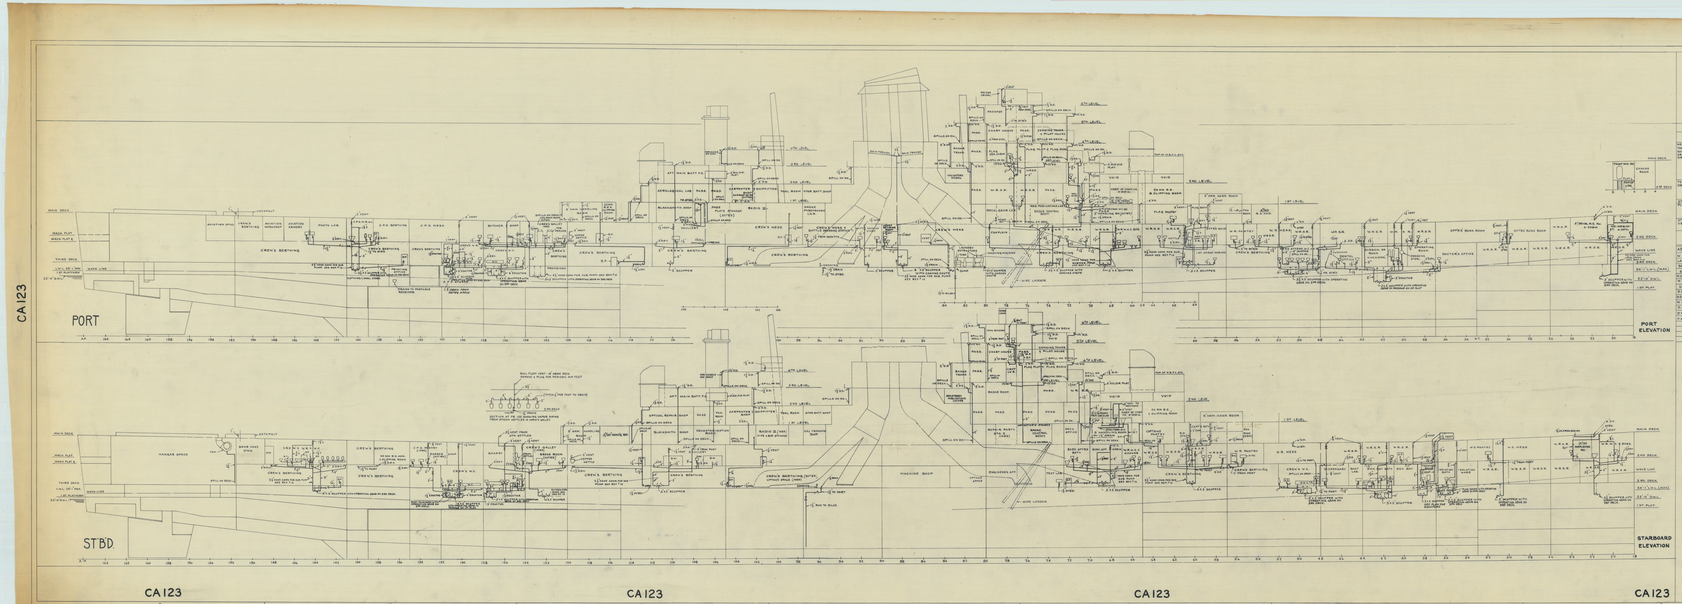



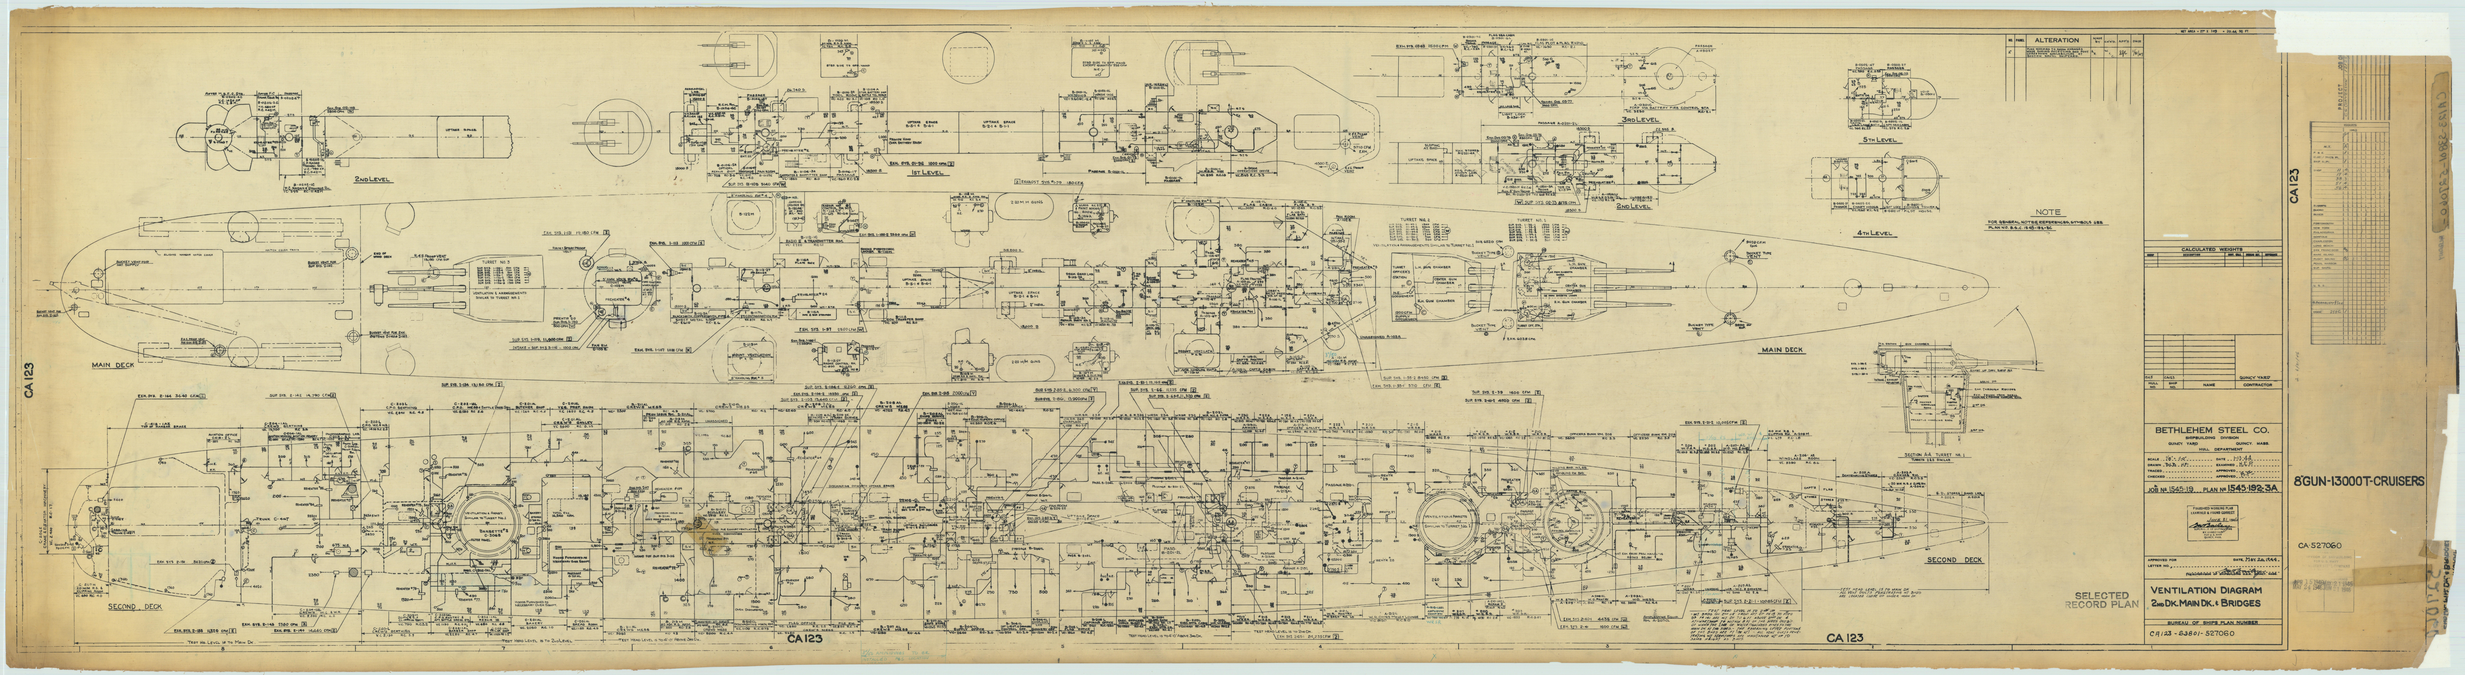
2ND LEVEL
1ST LEVEL
3RD LEVEL
5TH LEVEL
4TH LEVEL
MAIN DECK
SECOND DECK
SECTION A-A
NOTE
SELECTED RECORD PLAN
CA123
CA 123
8"GUN-13000T-CRUISERS
CA 527060
BETHLEHEM STEEL CO.
QUINCY, MASS.
HULL DEPARTMENT
JOB NO 1545-19 PLAN NO 1545-192-3A
VENTILATION DIAGRAM
2nd DK. MAIN DK. & BRIDGES
BUREAU OF SHIPS PLAN NUMBER
CA123-63801-527060

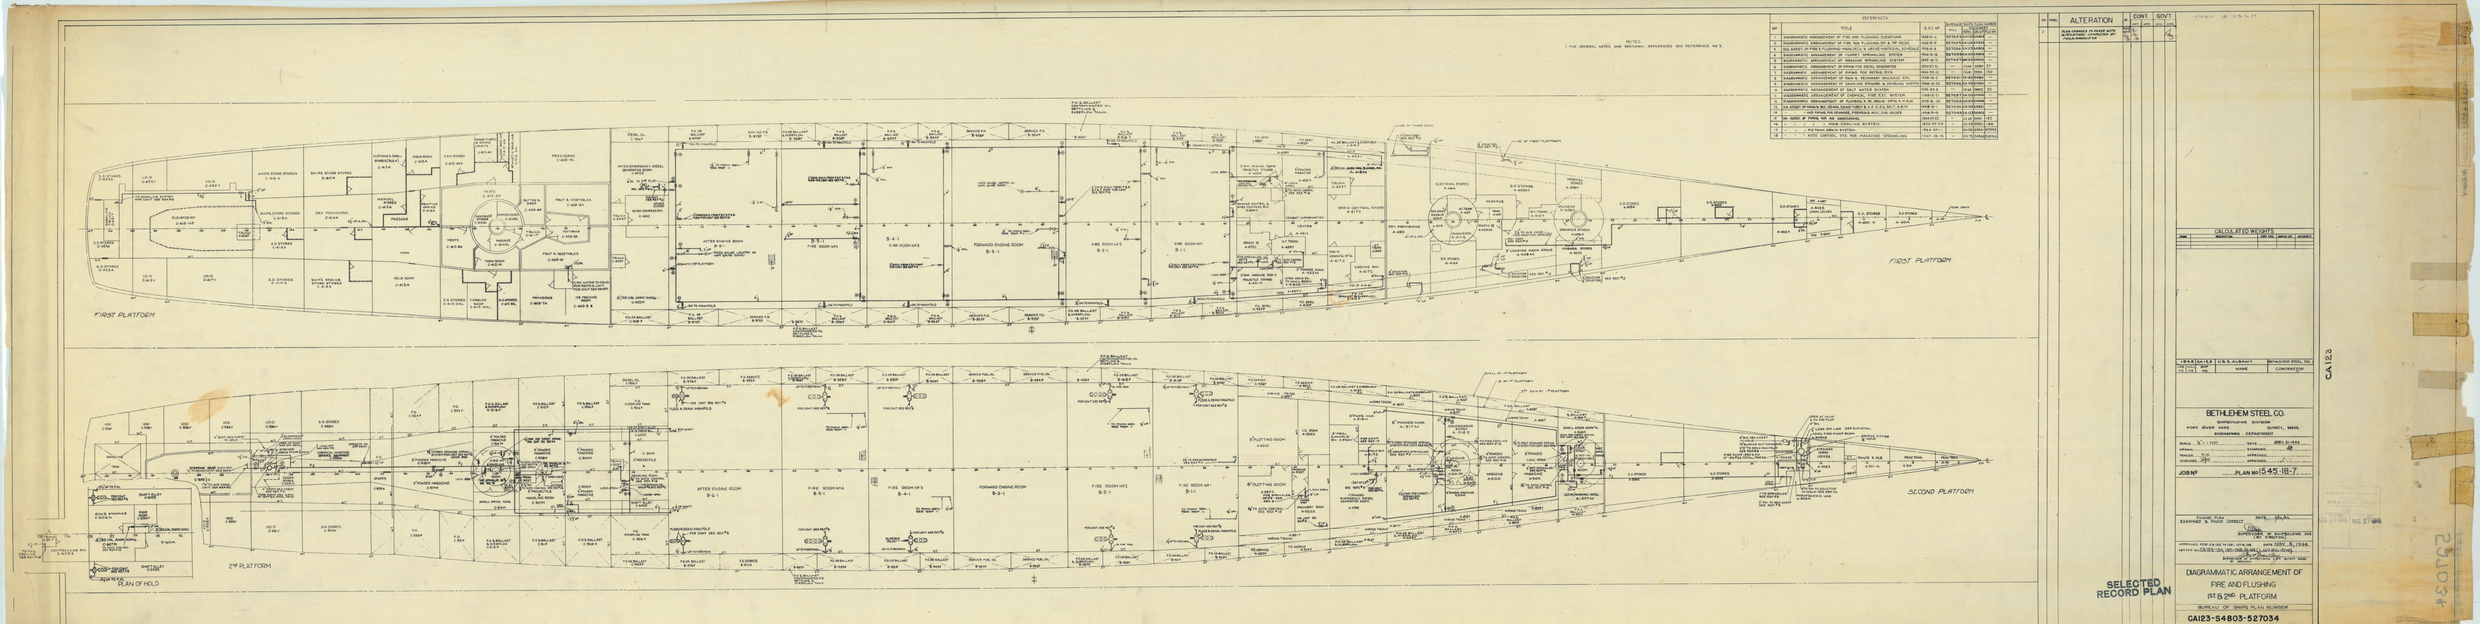

NOTES:
1. FOR GENERAL NOTES, AND ADDITIONAL REFERENCES SEE REFERENCE NO 3.

REFERENCES

NO	TITLE	B.S.I. NO	INSTALLATION PLANS (SHEET NO.)	CONTRACT PLANS (SHEET NO.)

NO	DATE	ALTERATION	BY	CONT. NO.	GOVT. NO.
1	AUG 21 1946	PLAN CHANGED TO REVISE PIPING ARRANGEMENT IN VICINITY OF FIRE PUMP NO 3	WWC		

CALCULATED WEIGHTS

ITEM	DESCRIPTION	UNIT WT.	UNITS WT.	REMARKS

TRANSMITTED BY	U.S.N. AGENCY	BETHLEHEM STEEL CO.
NAME	NAME	CONTRACTOR

BETHLEHEM STEEL CO.
SHIPBUILDING DIVISION
FORE RIVER YARD QUINCY, MASS.
ENGINEERING DEPARTMENT

SCALE 1/8" = 1'-0" TRACE APPL'D BY
DRAWN EXAMINED
TRACED APPROVED
CHECKED APPROVED

JOB NO PLAN NO 1545-18-7

FINISHED PLAN
EXAMINED & PASSED CORRECT
DATE JUL 24, 1946
SUPERVISOR OF INSPECTION AND TRIALS

APPROVED FOR AS-IS 10-18-; 12-6-18 DATE JUNE 5, 1946
APPROVED AS-IS 12-15-18; 12-31-18; 6-5-19 AS-BUILDING
BUREAU OF SHIPS, NAVY DEPARTMENT, WASHINGTON, D.C.


BUREAU OF SHIPS PLAN NUMBER
CA123-S4803-527034

SELECTED RECORD PLAN

CA123

CA123

CA123

CA123

29103

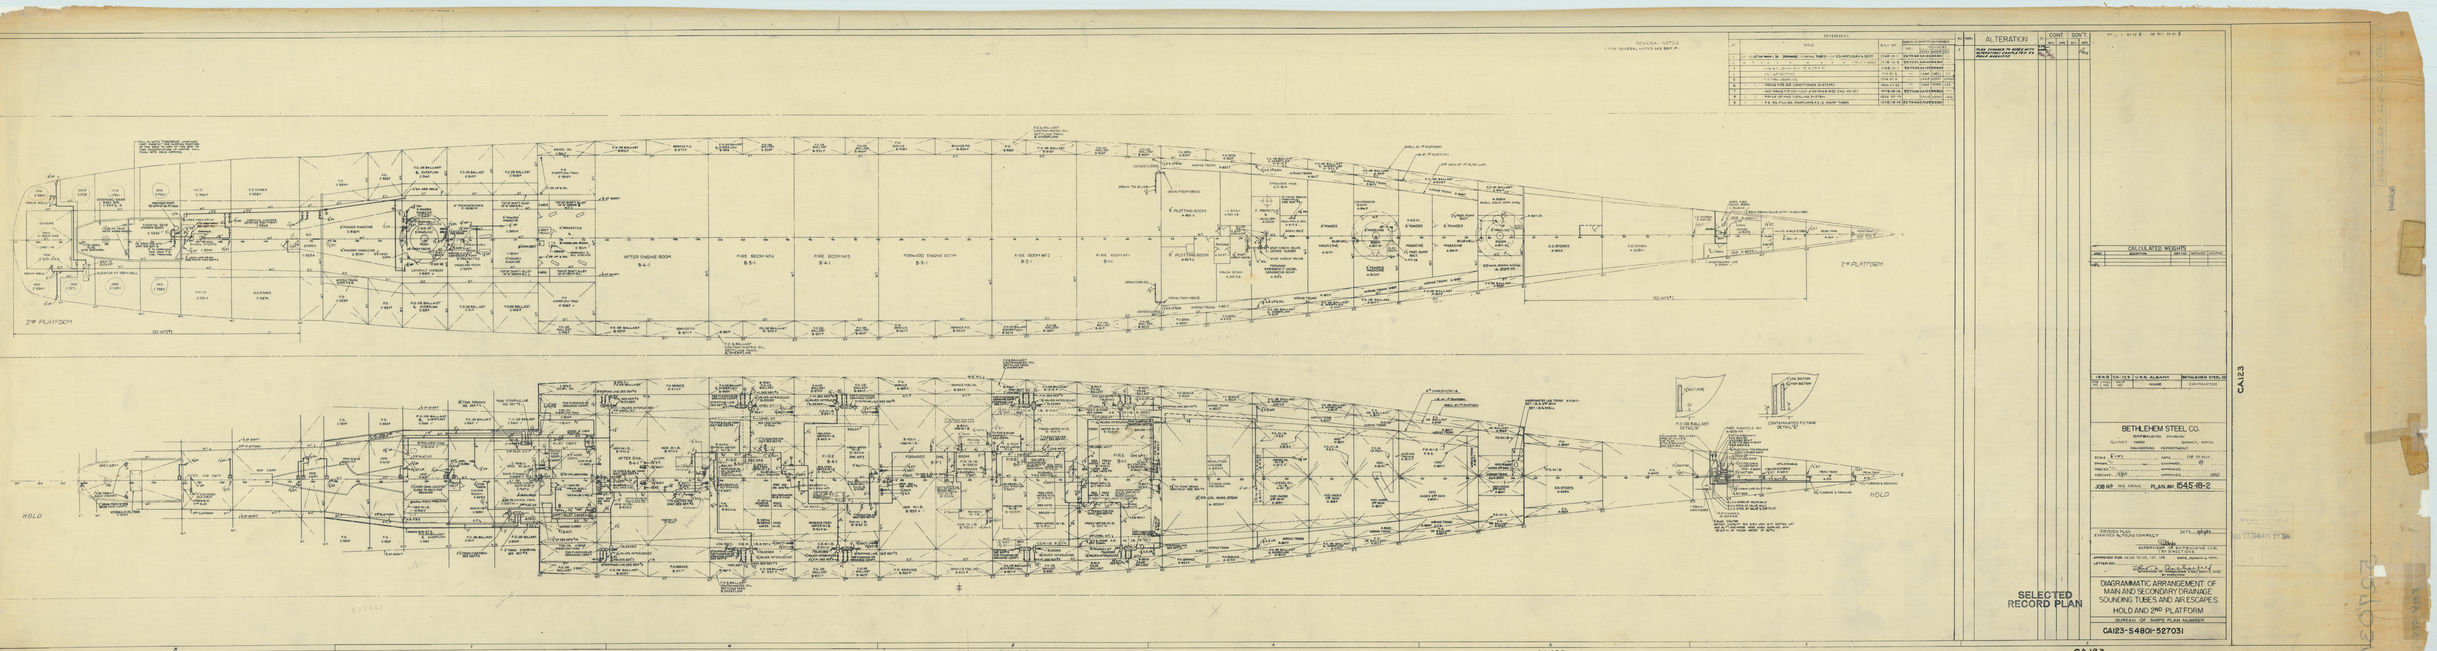

GENERAL NOTES
FOR GENERAL NOTES SEE SHT. 1

NO.	TITLE	SHEET NO.	SHEETS OF WHICH CONTINUED
17	[illegible]	B-5-1	[illegible]

NO.	ALTERATION	CONT	GOVT
1	[illegible]	[illegible]	[illegible]

CALCULATED WEIGHTS

ITEM	ADDITION	LBS. TON	MOMENT ARM
[illegible]	[illegible]	[illegible]	[illegible]

1945	CA-123	U.S.N. ALBANY	BETHLEHEM STEEL CO.
NO.	DATE	NAME	CONTRACTOR

BETHLEHEM STEEL CO.
SHIPBUILDING DIVISION
QUINCY, MASS.
FRAMING PERSPECTIVE

SCALE 1/4" DATE [illegible]
DRAWN [illegible] APPROVED [illegible]
TRACED [illegible] APPROVED [illegible] 1952

JOB NO. 1945 ABOVE PLAN NO. 1545-18-2

FINISHED PLAN EXAMINED & FOUND CORRECT DATE [illegible]
[illegible]
SUPERVISOR OF SHIPBUILDING U.S.N.
BETHLEHEM STEEL CO.

APPROVED FOR USE TO US. 1ST. LTR. DATED JANUARY 6, 1944
LETTER NO. [illegible]
[illegible]
BUREAU OF SHIPS

DIAGRAMMATIC ARRANGEMENT OF MAIN AND SECONDARY DRAINAGE, SOUNDING TUBES AND AIR ESCAPES
HOLD AND 2ND PLATFORM
BUREAU OF SHIPS PLAN NUMBER
CA123-S480H-527031

SELECTED RECORD PLAN

CA123

CA123 CA123 CA123 CA123